



**NOTES:**

1. ALL LEVELS ARE IN METRES, UNLESS OTHERWISE STATED.
2. ANY DISCREPANCIES FOUND SHOULD BE REPORTED TO FOCUS SURVEYS LTD. AND ANY OTHER RELEVANT PARTIES.
3. THE COORDINATE SYSTEM IS BASED ON THE IRISH TRANSVERSE MERCATOR GRID LOCAL GRID, TRANSFERRED TO SITE BY THE ACTIVE NETWORK.
4. ALL LEVELS ARE RELATED TO AN ORDNANCE SURVEY SPOT HEIGHT OF 956m ORDNANCE DATUM, LOCATED TO THE EAST OF THE EXIT TO THE SITE, ON MAIN STREET.
5. ALL LEVELS ARE RELATED TO A SITE TBM WHICH IS A HILT-NAIL WITH ORANGE TAPE SET IN THE ROADWAY TO THE SOUTH-WEST OF THE SITE, ITS ELEVATION BEING 929m ORDNANCE DATUM, AS SHOWN ON THIS DRAWING.
6. UNDERGROUND SERVICES ARE ASSUMED TO RUN IN STRAIGHT LINES.
7. LEVELS IN RED ARE TOP OF WALL LEVELS.

**LEGEND:**

- MH DENOTES MANHOLE
- CL DENOTES MANHOLE COVER LEVEL
- DP DENOTES DOWNPIPE
- RG DENOTES ROAD GULLY
- IC DENOTES INSPECTION COVER
- LS DENOTES LAMP STANDARD
- FH DENOTES FIRE HYDRANT
- OH DENOTES OVERHEAD
- PO DENOTES PIPE OUTLET
- GT DENOTES GULLY TRAP
- TB DENOTES TOP OF BANK
- BB DENOTES BOTTOM OF BANK
- AV DENOTES AIR VALVE
- IL DENOTES INVERT LEVEL
- VV DENOTES WATER VALVE
- ER DENOTES EARTH ROD

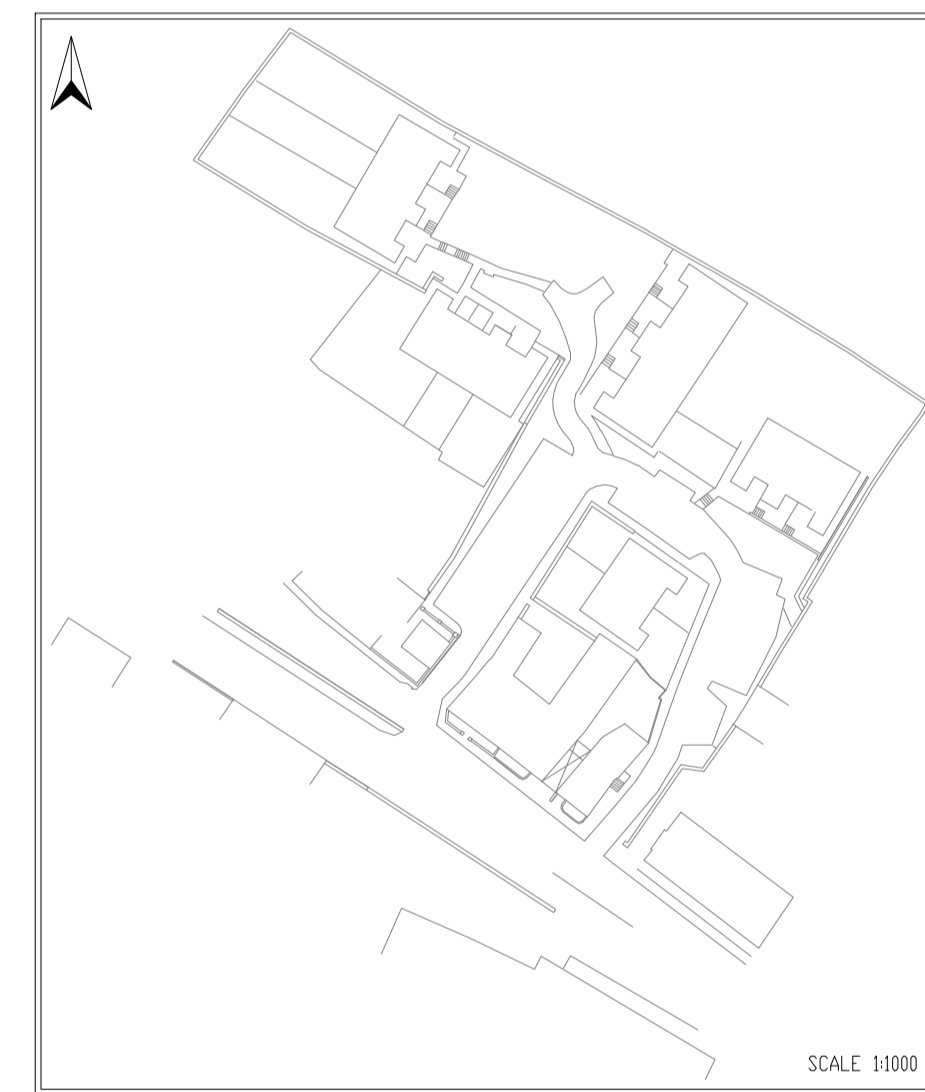

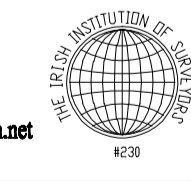A	02-08-07	AS BUILT SURVEY OF DEVELOPMENT
REVISION	REVISION DATE	DESCRIPTION OF REVISION
<b>FOCUS</b>		
Focus Surveys Ltd, O'Connell Avenue, Turner's Cross, Cork. Tel: 021-4314555 Fax: 021-4975907 e-mail: focusurveys@eircom.net		
		
TITLE <b>TOPOGRAPHICAL SITE SURVEY.</b>		
SURVEY LOCATION XXXXXXXXXXXXXXXXXXXX XXXXXXXXXXXXXXXXXXXX		
CLIENT XXXXXXXXXXXXXXXXXXXX XXXXXXXXXXXXXXXXXXXX		
SCALE	1:250	DRAWING NAME
SURVEYED BY	M.B.	REV. A
DATE	08-07-08	02-069_1
DRAWN BY	M.B.	
DATE	11-07-08	
CHECKED BY	D.C.	